



SEWER PERMIT

CITY PROJECT NO: _____


CITY OF SEDRO-WOOLLEY PUBLIC WORKS DEPARTMENT
325 METCALF ST., SEDRO-WOOLLEY, WA 98284 • (360) 855-0771

OWNER: _____ PHONE: _____

JOB ADDRESS: _____ LOT: _____

FEES: INSPECTION: _____ CAPITAL FACILITIES FEE: _____
OSS INSPECTION: _____ DECOMMISSION CREDIT: (IF APPLICABLE) _____
OTHER: _____ COOK RD/TRAIL RD CONNECTION FEE: _____
ULID SPECIAL CONNECTION FEE: _____

DATE ISSUED: _____ ISSUED BY: _____ TOTAL: _____

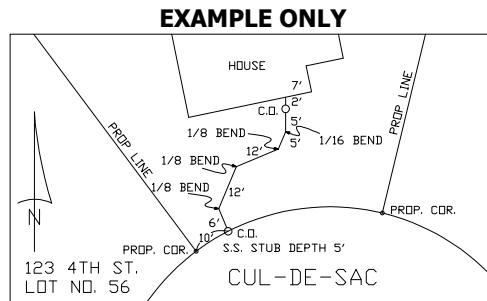

N.T.S. (Not-To-Scale)

At the time of inspection, please give inspector a legible and accurate (straight edge) sketch of the installation. This sketch should include: plot plan, house placement, north arrow, sewer line (show distances to clean-out, size and degree of bends, city stub and depth to stub), and size and type of line. SEE EXAMPLE ABOVE.

ALL SIDE SEWER WORK WILL CONFORM TO THE FOLLOWING CRITERIA:
(BEYOND THE RIGHT-OF-WAY CLEANOUT. SEE THE SWPWDS FOR 'CITY SIDE' WORK)

- 1. A licensed bonded contractor must be employed for work in the public right-of-way.
2. All side sewer pipe and fittings will be rubber gasketed PVC, and shall meet ASTM3034 - SDR 35 specifications.
3. Sewer pipe must have at least 30 inches cover at the property line and 18 inches on private property.
4. All side sewer installations will include a cleanout at the foundation, a cleanout at the property line and a cleanout every 100 feet in long pipe runs.
5. Pipe will be bedded 6 inches under and 6 inches over with pea gravel or buckshot only.
6. All ditches within the public right-of-way will be safe guarded with barricades and must not be left open overnight.
7. Backfill all trenches after inspection and clean up street, including pavement restoration.
8. Any portion of the installation covered or backfilled without approval by the inspector will be uncovered. NO EXCEPTIONS.
9. Fixtures below street elevation will be equipped with backflow preventer.
10. Requests for inspection will be made at least 24 hours in advance by call to the Inspection line (360) 855-0139.
11. The Owner agrees to maintain the side sewer.
12. The City of Sedro-Woolley accepts no responsibility for the quality of workmanship, the accuracy of utility locates, or sewer system drawings, or any damage which might result from this work.

CONTRACTOR: _____ CONTRACTOR LICENSE # _____ / EXPIRATION DATE: _____

CONTRACTOR ADDRESS: _____ PHONE NO. _____

SW BUSINESS LICENSE REQUIRED: YES _____

I hereby certify that the connection has been made as shown.

INSPECTOR: _____ DATE: _____

****SKETCH OF THE INSTALLATION****